APPLICATION FOR BUILDING PERMIT

The Village of Irvington | 85 Main St | Irvington NY 10533

Application Number:	207	Date:	02/14/2022
Job Location:	1 LANGDON AVE	Parcel ID:	2.170-83-1
Property Owner:	Jessica Soare	Property Class:	1 FAMILY RES
Occupancy:		Zoning:	
Common Name:			

Applicant	Contractor
Jessica Soare	Georg Ivanoff
N/A	Sunrise Building and Remodeling, Inc.
1 LANGDON AVEIRVINGTON NY 10533	510 North State Road Briarcliff Manor NY 10510
845-642-4237	914-762-8453

Description of Work

Type of Work:	Windows/ Doors Replacement	Applicant is:	Owner				
Work Requested by:	The Owner	In association with:					
Cost of Work (Est.):	18000.00	Property Class:	1 FAMILY RES				

Description of Work

Installation of 2 egress window wells including:

Excavation for 2 window wells


Removal of current windows

Framing for 2 windows

Installation of 2 high performance Anderson 400 casement windows, white with screens and grills with standard white traditional hardware

- -Installation of Boman and Kemp window wells with escape ladder and safety grate
- -Trimming of 2 new windows
- -Installation of insulation
- -Sheetrock

Please Note: Completing the application does not constitute a permit to commence construction. To obtain

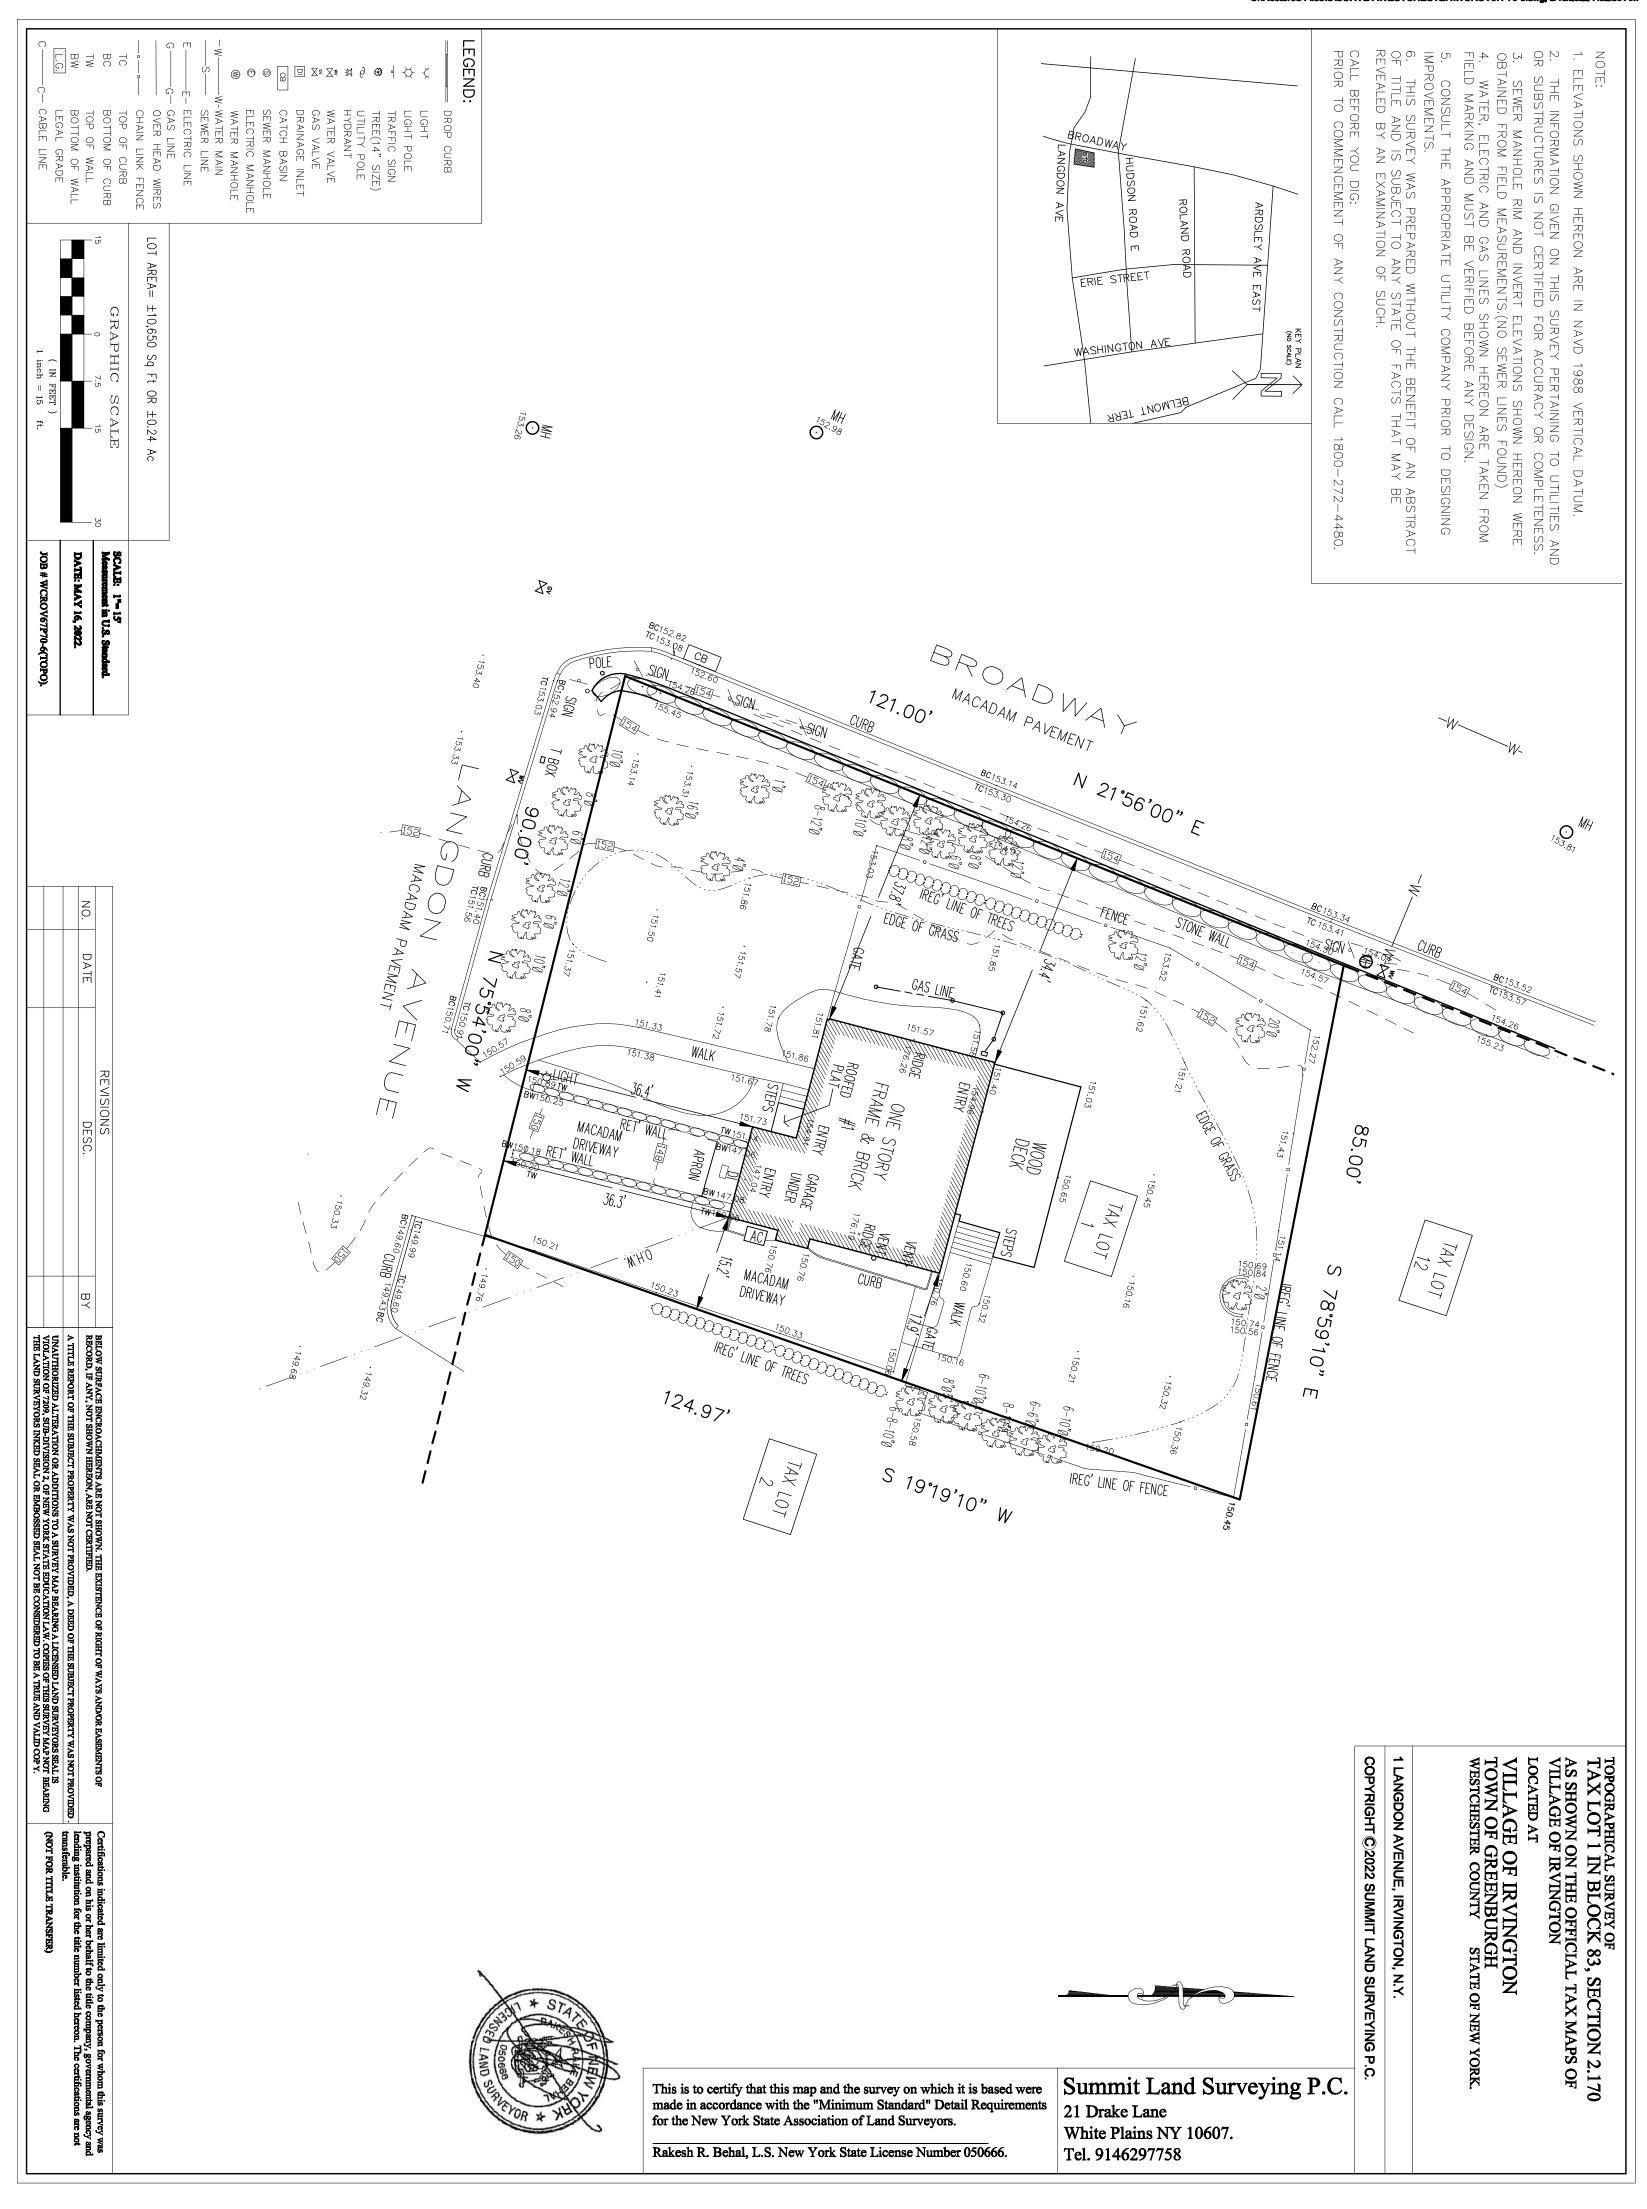

BUILDING CODE AND REFERENCE STANDARDS:

THE 2020 RESIDENTIAL CODE OF NEW YORK STATE, AS ADOPTED AND MODIFIED BY THE LOCAL JURISDICTION SHALL GOVERN THE DESIGN AND CONSTRUCTION OF THIS PROJECT. REFERENCE TO A SPECIFIC SECTION IN THE CODE DOES NOT RELIEVE THE CONTRACTOR FROM COMPLIANCE WITH THE ENTIRE MATERIALS REFERENCE STANDARDS. THE LATEST EDITION OF THE MATERIALS REFERENCE STANDARDS SHALL BE USED. EXISTING BUILDING SHALL COMPLY WITH [NY] APPENDIX J FOR EXISTING BUILDINGS AND STRUCTURES.

DETAILS SCOPE OF WORK DESCRIPTION

EXISTING SINGLE FAMILY RESIDENCE -LEVEL 2 ALTERATION PERMIT PLANS


- 1. PROPOSED FINIHSED BASEMENT WITH NEW EGRESS WINDOW WELLS

CLASSIFICATION OF WORK- ALTERATION LEVEL 2

- THE WORK PERFORMED ON THE EXISTING SINGLE FAMILY RESIDENTIAL DWELLING SHALL BE CLASSIFIED AS AN **ALTERATION - LEVEL 2 (AJ301.5) , WHICH INCLUDES THE** RECONFIGURATION OF SPACES AS DEFINED IN THE WORK DESCRIPTION. THE USE CLASSIFICATION SHALL BE RESIDENTIAL **GROUP R3 WITH CONSTRUCTION TYPE V.** EXISTING BUILDINGS SHALL COMPLY WITH [NY] APPENDIX J FOR EXISTING BUILDINGS AND STRUCTURES.



AERIAL VIEW

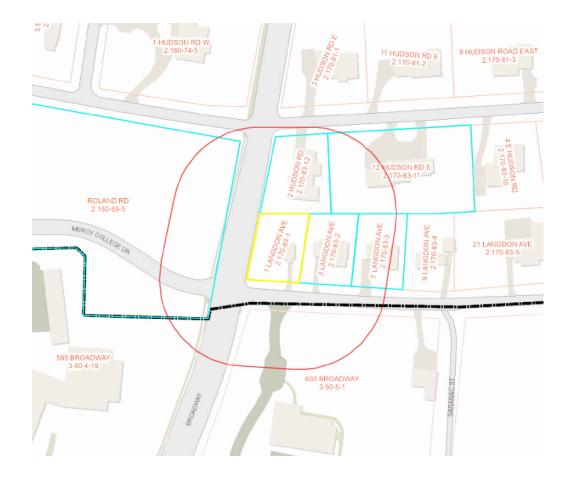




Owner	Prop Address	Printkey
SOARE, JESSICA E.	1 LANGDON AVE	2.170-83-1
HAIDER, JAWAD	12 HUDSON RD E	2.170-83-11
DONEHOWER, ROBERT.	2 HUDSON RD	2.170-83-12
MERCY COLLEGE	ROLAND RD	2.160-69-5
SCHAEFER, PAUL	7 LANGDON AVE	2.170-83-3
HARTNETT, JILL A.	3 LANGDON AVE	2.170-83-2

ADJACENT PROPERTY INFORMATION

ARCHITECTURAL REVIEW BOARD APPLICATION:

1 LANGDON AVENUE IRVINGTON, NY 10533

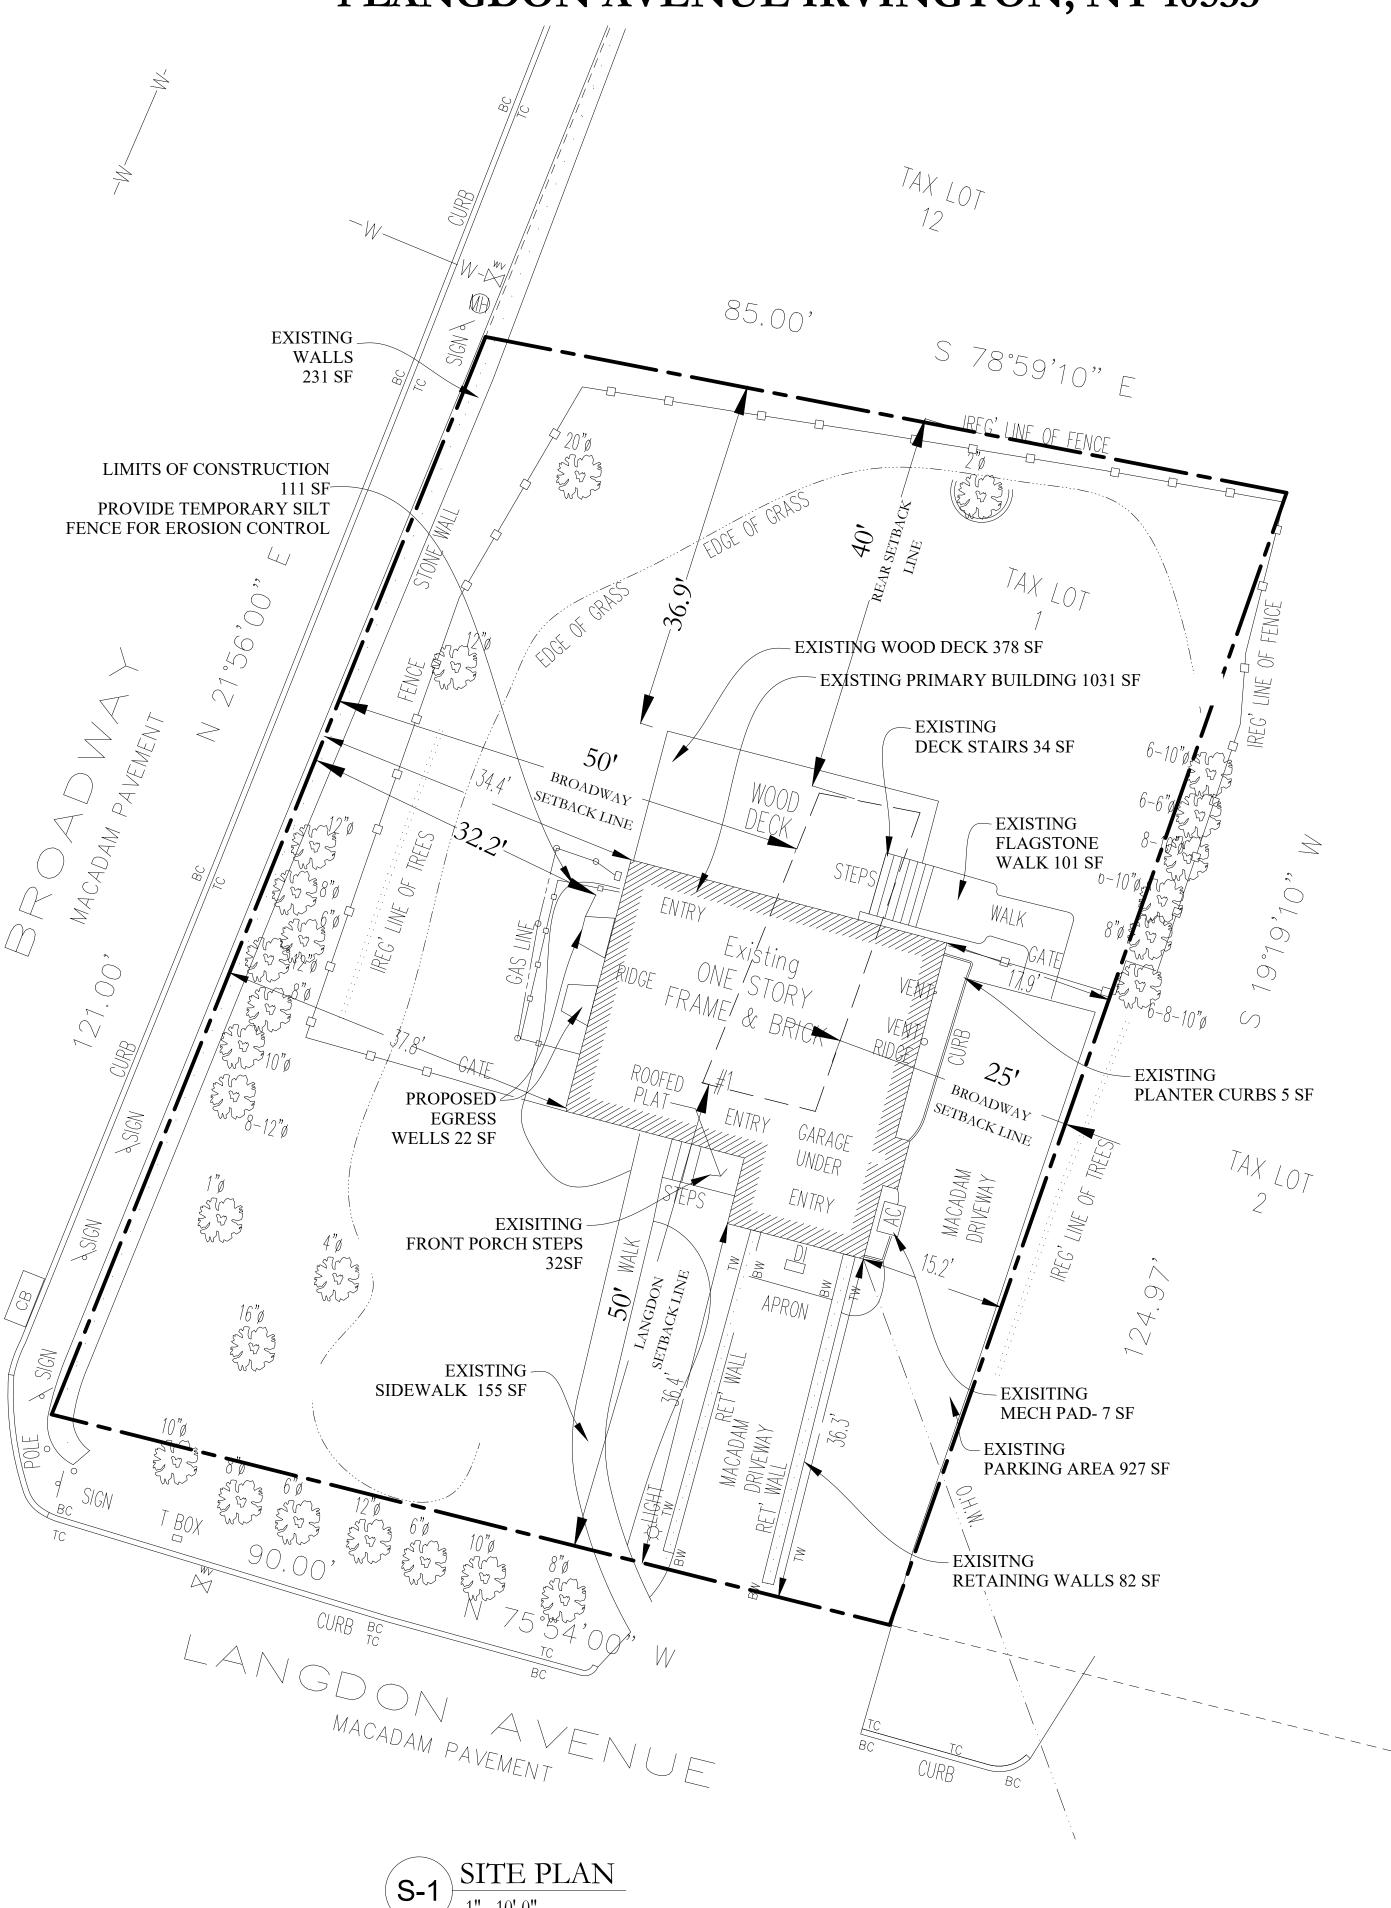

Parameter	Existing	Proposed	Allowable			7	oning Ref	erence Tak	ole		
oning District	1F-40	1F-40	1F-40	2F	MF	1F-5	1F-10	1F-20	1F-40	1F-60	11
ot Area (SF)	10650	10650	40,000	5,000	10,000	5,000	10,000	20,000	40,000	60,000	80
ront Yard Setback (FT)	36.3	36.3	50	30	30	30	30	35	50	60	
ide Yard Setback 1 (FT)	34.4	34.4	25	10	15	10	15	15	25	30	
de Yard Setback 2 (FT)	15.2	15.2	25	10	15	10	15	15	25	30	
ear Yard Setback (FT)	36.9	36.9	40	30	30	30	30	35	40	60	
ot Width (FT)	85	85	150	50	85	50	85	100	150	200	
ot Depth (FT)	121	121	150	100	100	100	100	125	150	200	

Buffers	Applicability	Existing	Proposed	Allowable	Reference
Old Croton Aqueduct	No			30	§224-50, All properties along OCA
Broadway "Existing" Lot1	Yes	34.4	32.2	50	§224-51 B, Properties along Broadway
Broadway "New" Lot ¹	No			125	§224-51 B, Properties along Broadway
Cyrus Field Road	No			75	§224-51 A

"New" Lot shall be any new subdivisions, tear downs, or any development involving a modification of more than 50% of an existing structure

Overlay Disticts	Applicabilit	Reference
View Preservation	No	§224-149, All properties west of Broadway
Historic District	No	§224-196, As shown on Zoning Map
Historic Building	No	§224. Appendix A

IRVINGTON ZONING WORKSHEET (CONT.)

lowable Height	(§224-3)		
ameter	Existing	Proposed	Allowable
ries	2	2	2.5
Elevation ¹	176.26	176.26	1
Elevation ²	150.2	150.2	ı
ght (HP-MP)	26.06	26.06	35 (or 40 ³)

¹ HP - Highest Point of the surface of the roof, except as noted in §224-3 Height A (2). ² MP - Measuring Point, the lowest point at the foot of any portion of the building of the lower of: (a) the finished grade; and (b) the

grade prior to construction, filling or grading. §224-3 Height B (2).

If building envelope grade criteria are met, §224-3.Height B.(3), 40-feet may be used. Only apply if building envelope grade criteria are met, §224-3. Height B.(3), Height from Average Existing Grade (AEG). See Below.

Average Existing Grade, §224-3.Height B.(3)

Note: Business District see 224-3 Height B. (1). Exception in accordance with 224-3 Height B (3), below.

Parameter	Value	Unit	Notes
Area within Building Envelope (BE)	2982	sf	
Area of envelope with Steep Slopes ≥15% (SS)	0	sf	Provide Slope Diagram
Percent of SS (BE÷SS x 100)	0.0	%	Must be ≥50%
Is roof pitch for 80% of roof a min. of 5" on 12"?	No		Provide Roof Sketch
Average Existing Grade (AEG) Elevation at Periphery of Building	151	ft	Provide AEG Calculations
Critoria Satisfied?	NO		

Architect or Professional Engineer, and to the best of my knowledge it is in accordance with Section 224 of the Village Code. I understand that engaging in acts of gross incompetence or gross negligence, permitting or aiding an unlicensed person to perform activities requiring a license, or practicing beyond the scope of the profession is considered professional misconduct and punishable in



ALLOWABLE COVERGE BY LOT SIZE

LOT COVERAGE WORK SHEET

EO III IDEE CO									
		Two Family 1F-	Multi Family						
	Zoning District	5	1F-10	1F-20	1F-40	1F-60	1F-80		
	Lot Coverage	24%	20%	16%	12%	8.33%	6.75%		
	Lot Coverage	up to 5,000 sqft	up to 10,000sqft	up to 20,000sqft	up to 40,000sqft	up to 60,000sqft	up to 80,000sqft		
	Coverage Bonus	16%	12%	6%	4%	2%	2%		
	over minimum lot size	over 5,000 sqft	over 10,000sqft	over 20,000sqft	over 40,000sqft	over 60,000sqft	over 80,000sqft		
Zoning Dist.	Lot Size	Base Allowable	Coverage (SF)	Bonus Allowab	e Coverage (SF)	Total Allowa	ble Coverage		

ADDITIONAL ONLY OTHER BUILDING OTHER BUILDIN PARKING AREA (IF NOT PART OF DRIVWAY SIDE WALK (: SIDE WALK (2) SIDE WALK (3) FRONT PORCH (STEPS) PATIO (1 MECHANICAL EQUIPMENT PADS (1)

GARDEN WALLS RETAINING WALLS POOL PATIOS POOL EQUIPMENT Rear Wood Deck Rear Deck Stairs Individual Total Greater than Allowable Greater than Existing

LOT COVERAGE CHECK LIST Provide existing coverage diagram on site plan

rovide proposed coverage diagram on site plan

icensed Registered Architect or Professional Engineer, and to the best of my knowledge it is in accordance with Section 224-13 Building Coverage of the Village Code. I understand that engaging in acts of gross incompetence or gross negligence, permitting or aiding an unlicensed person to perform activities requiring a license, or practicing

not exceed the following: (see chart above) [Amended 6-26-2003 by L.L. No. 7-2003] B. Oversized lots. Notwithstanding Subsection A of this section, the sum of all areas covered by all principal and accessory buildings in lots located in 1F-5, 1F-10 and 1F-20 Districts shall not exceed that which would be permissible under Subsection A if the lot were located in the district having the largest minimum lot size smaller than the area of

1F-40 District and therefore would 6,400 square feet (4,800, plus 4% of 80,000 minus 40,000) C. For the purposes of determining coverage, drivway shall not be considered as principal and accessory building



the lot, for example, the coverage permitted on a site of 80,000 square feet in an 1F-10 District would be determined by reference to the maximum coverage in the

THE BUILDING INSPECTOR OR VILLAGE ENGINEER MAY REQUIRED ADDITIONAL EROSION CONTROL MEASURES IF DEEMED APPROPRIATE TO MITIGATE UNFORESEEN SILTATION AND EROSION OF DISTURBED SOILS

AS BUILT DRAWINGS OF SITE IMPROVEMENTS SHALL BE SUBMITTED TO THE VILLAGE BUILDING INSPECTOR FOR REVIEW PRIOR TO OBTAINING CERTIFICATE OF OCCUPANCY

SURVEY REFERENCED SUMMIT LAND SURVEYING, PC 21 DRAKE LANE WHITE PLAINS, NY 10607 RAKESH BEHAL # 050666 DATED: MAY 16 2022

2017-11-21 IPB Coverage Work Sheet



www.ResReal.com (914)-330-7712

361 Route 202 - Suite #7 Somers, NY 10589

PROPERTY INFORMATION: PREPARED BY: JMS ENGINEERING SERVICES, PC PROJECT LOCATION: 1 LANGDON AVENUE PROJECT TOWN: IRVINGTON, NY BUILDING DEPARTMENT: VILLAGE OF IRVINGTON PROPERTY IDENTIFICATION: 2.170-83-1

OCCUPANCY: SINGLE FAMILY DWELLING

ZONING CODE: 1F-40

CHECKED: APPROVED: 0 11/05/2022

SEAL & SIGNATURE:

> JOHN M. SCAVELLI PE LICENSE # 095178 JMS ENGINEERING SERVICES, PC


IT IS A VIOLATION OF STATE LAW FOR ANY PERSON UNLESS DIRECTED BY A REGISTERED ARCHITECT OR PROFESSIONAL ENGINEER TO ALTER THIS ITEM IN ANY WAY.


PROJECT:

1 Langdon Avenue Irvington, NY 10533

DRAWING TITLE: ARB SHEET 1

ARB-101

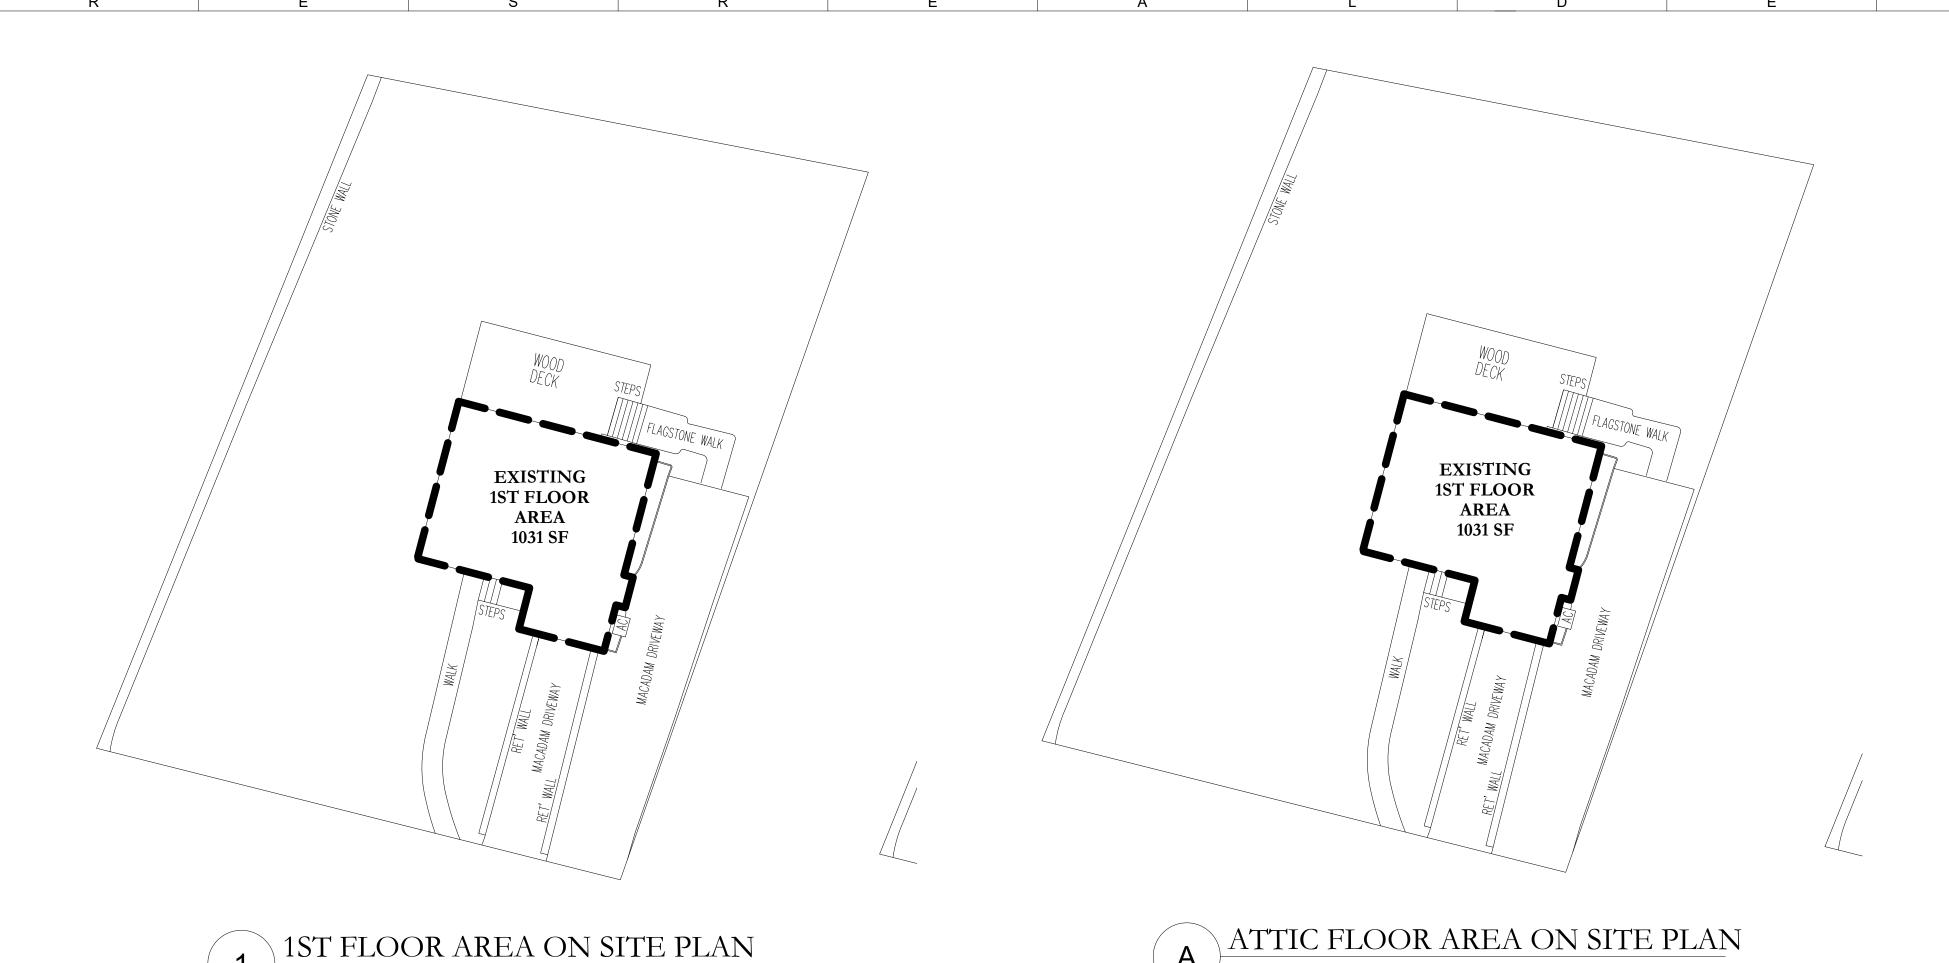

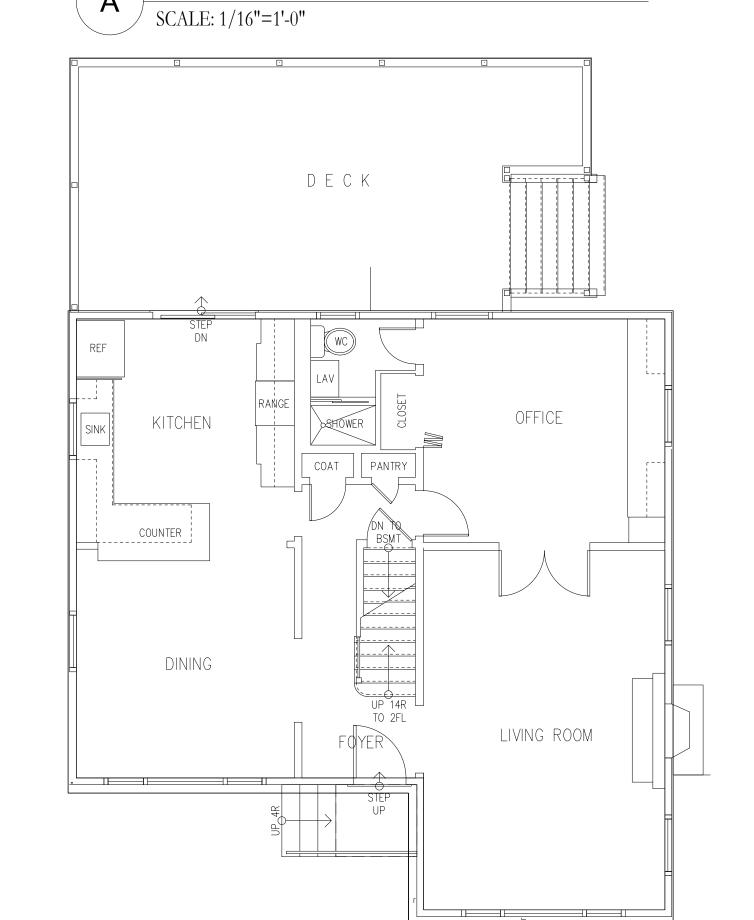

1ST FLOOR PLAN

ALLOWABLE FLOOR AREA RATIO (F.A.R.)

Allowable Floor Area: 2,982 SF F.A.R. WORK SHEET² 1) Basement area taken from outside walls. If exposed front basement wall is less than I feet in height for existing and proposed grades, that portion multiplied by the depth of the building is excluded. 2) First floor area taken from outside walls 1,031 Second floor area from outside walls Third floor area from outside walls Area where ceiling height exceeds 12 ft. 3) Attic area taken from outside walls of the floor below 1,031 (a) Attic does not currently exist - 0% (b) Attic is unfinished, has a hatch or drop stair, and height is less than 7'-6" - 0% (c) Attic is unfinished, has a hatch or drop stair, and height is 7'-6" or greater - 50% F: 100% to F.A.R. F: 100% to F.A.R. (d) Attic is unfinished, has a staircase or door, and height is less than 7'-6" - 50% (e) Attic is unfinished, has a staircase or door, and height is 7'-6" or greater - 100% (f) Attic is finished - 100% Area of Attic Applied to F.A.R. Accessory building: (a) Basement area to outside walls (b) First floor area to outside walls (c) Second floor area to outside walls (d) Third floor area to outside walls Garage area(s) taken from outside walls Deductions⁴: (a) on lots of 9,999 SFf or less there is a deduction of up to 250 SF (b) on lots of 10,000 SF ormore there is a deduction of up to 400 SF

F.A.R. CHECK LIST X Provide existing F.A.R. diagram for each floor on the site plan

X Provide proposed F.A.R. diagram for each floor on the site plan John M Scavelli, PE I represent that I am wholly and completely responsible for the accuracy of the information above as the NYS Licensed Registered Architect or Professional Engineer, and to the best of my knowledge it is in accordance with Section 224, Article XXII. Residential Floor Area Ratio of the Village Code. I understand that engaging in acts of gross incompetence or gross negligence, permitting or aiding an unlicensed person to perform activities requiring a license, or practicing beyond the scope of the profession is considered professional misconduct and punishable in accordance with NYS Educational Law.

1. Refer to §224-136A for maximum residential floor area ratios (F.A.R.). When a lot size is between two Max F.A.R., the greater of the two values shall be taken. 2. All area measurements shall be taken to the outside face of exterior walls.

Area of garage deducted from F.A.

Percentage of Allowable F.A.

Percent Greater then Allowable

Percent Greater then Existing

Total Floor Area and F.A.R. 2,062 0.19 2,062 0.19


0.0%

69.1%

0.0%

0.0%

2017-11-16 IPB F.A.R. Work Sheet

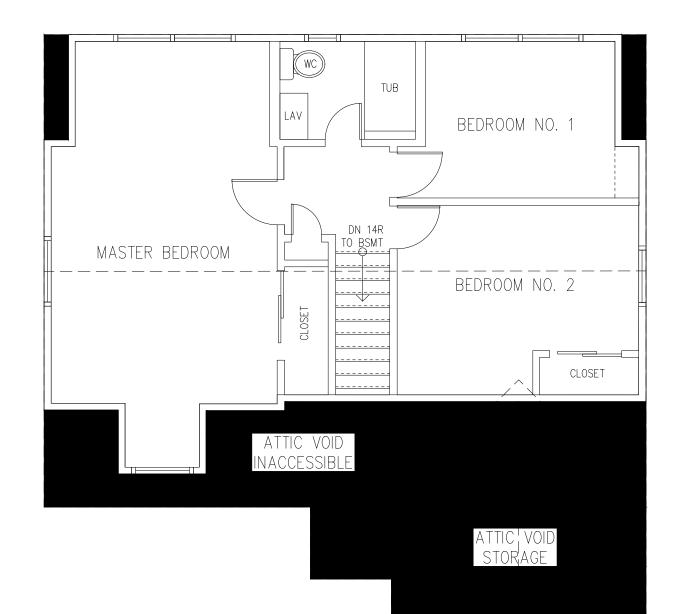

ATTIC FLOOR PLAN

Architecture & Engineering Services
For Homes

www.ResReal.com (914)-330-7712

361 Route 202 - Suite #7 Somers, NY 10589

PROPERTY INFORMATION: PREPARED BY: JMS ENGINEERING SERVICES, PC PROJECT LOCATION: 1 LANGDON AVENUE PROJECT TOWN: IRVINGTON, NY BUILDING DEPARTMENT: VILLAGE OF IRVINGTON PROPERTY IDENTIFICATION: 2.170-83-1 OCCUPANCY: SINGLE FAMILY DWELLING ZONING CODE: 1F-40

CHECKED: APPROVED: 0 11/05/2022 JMS JMS

SEAL & SIGNATURE:

> JOHN M. SCAVELLI PE LICENSE # 095178 JMS ENGINEERING SERVICES, PC


IT IS A VIOLATION OF STATE LAW FOR ANY PERSON UNLESS DIRECTED BY A REGISTERED ARCHITECT OR PROFESSIONAL ENGINEER TO ALTER THIS ITEM IN ANY WAY.

PROJECT:

1 Langdon Avenue Irvington, NY 10533

DRAWING TITLE: ARB

> SHEET 2 ARB-102

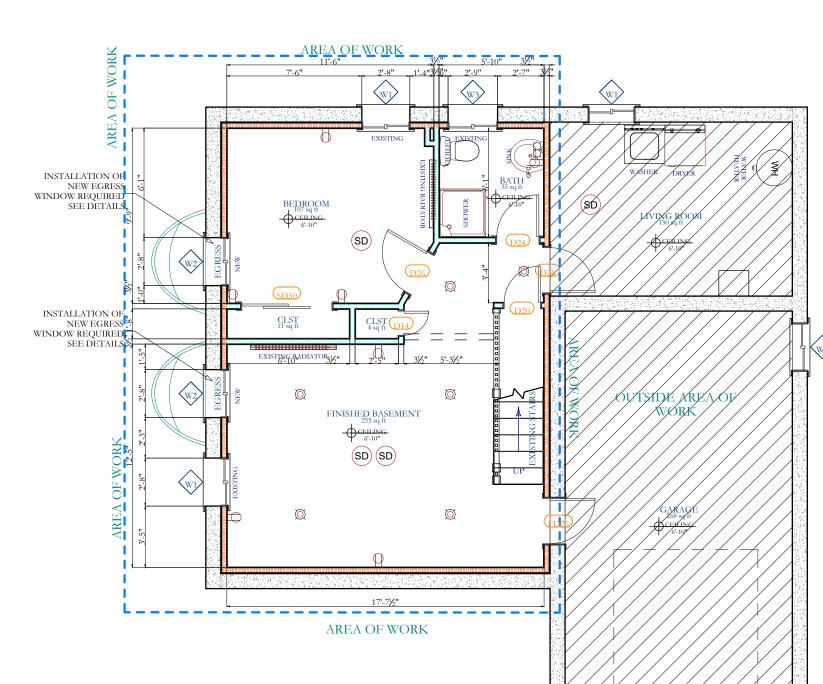



FRONT LEFT









REAR FACADE



Architecture & Engineering Services
For Homes

www.ResReal.com (914)-330-7712

361 Route 202 - Suite #7 Somers, NY 10589

PROPERTY INFORMATION:
PREPARED BY: JMS ENGINEERING SERVICES, PC
PROJECT LOCATION: 1 LANGDON AVENUE
PROJECT TOWN: IRVINGTON, NY
BUILDING DEPARTMENT: VILLAGE OF IRVINGTON
PROPERTY IDENTIFICATION: 2.170-83-1
OCCUPANCY: SINGLE FAMILY DWELLING
ZONING CODE: 1F-40

EXISTING ELEVATIONS SCALE: NTS

CONSTRUCTION SCHEDULE 1 LANGDON AVE LARCHMONT

ESTIMATED COMPLETION IN 3 WEEKS

	DATE	2/1/2023	2/2/2023	2/3/2023	2/4/2023	2/5/2023	2/6/2023	2/7/2023	2/8/2023	2/9/2023	2/10/2023	2/11/2023	2/12/2023	2/13/2023	2/14/2023	2/15/203	2/16/2023	2/17/2023	2/18/2023	2/19/2023	2/20/2023	2/21/2023	2/22/2023
IRVINGTON PLANNING & ZONING APPROVAL	2/1/2023																						
EXCAVATION	2/6/2023																						
DEMOLITION	2/11/2023																						
ROUGH FRAMING	2/16/2023																						
INSTALLATION	2/21/2023																						
INTERIOR TRIM & CLEANUP	2/26/2023																						
INSPECTION	3/2/2023																						

ESTIMATED CONSTRUCTION SCHEDULE
SCALE: NTS

CUT/ FILL VOL	LUMES
VOLUME OF CUT [CUBIC FEET]	88
VOLUME OF CUT [CUBIC YARDS]	3.26
VOLUME OF FILL [CUBIC FEET]	0
VOLUME OF FILL [CUBIC YARDS]	0

- 1. THERE IS NO PROPOSED USED OF FILL AS PART OF PROPOSED WORK
- THERE WILL BE EXCAVATION REQUIRED FOR PROPOSED WINDOW WELL INSTALLATION.
 CUT/FILL MATERIAL SHALL NOT BE IMPORTED TO OR EXPORTED FROM SITE.

C CUT/FILL VOLUMES

0 11/05/2022 JMS

SEAL & SIGNATURE:

> JOHN M. SCAVELLI PE LICENSE # 095178 JMS ENGINEERING SERVICES, PC

IT IS A VIOLATION OF STATE LAW FOR ANY PERSON UNLESS DIRECTED BY A REGISTERED ARCHITECT OR PROFESSIONAL ENGINEER TO ALTER THIS ITEM IN ANY WAY.

PROJECT:

1 Langdon Avenue Irvington, NY 10533

DRAWING TITLE: ARB

SHEET 3

ARB-103

WORK OVERVIEW

1. SINGLE FAMILY RESIDENCE -LEGALIZATION PERMIT PLANS FOR FINISHED BASEMENT LEVEL SPACE.

BUILDING CODE AND REFERENCE STANDARDS:

THE 2020 RESIDENTIAL CODE OF NEW YORK STATE, AS ADOPTED AND MODIFIED BY THE LOCAL JURISDICTION SHALL GOVERN THE DESIGN AND CONSTRUCTION OF THIS PROJECT. REFERENCE TO A SPECIFIC SECTION IN THE CODE DOES NOT RELIEVE THE CONTRACTOR FROM COMPLIANCE WITH THE ENTIRE MATERIALS REFERENCE STANDARDS. THE LATEST EDITION OF THE MATERIALS REFERENCE STANDARDS SHALL BE USED. EXISTING BUILDING SHALL COMPLY WITH [NY] APPENDIX J FOR EXISTING BUILDINGS AND STRUCTURES.

AS-BUILT DRAWING NOTES:

- 1. THESE DRAWINGS HAVE BEEN PREPARED TO DOCUMENT AS-BUILT EXISTING CONDITIONS OF THE REFERENCED PROPERTY.
- 2. ANY NEW CONSTRUCTION PERFORMED FOR LEGALIZATION PURPOSES SHALL BE PERFORMED BY LICENSED CONTRACTORS AS REQUIRED BY THE LOCAL AUTHORITIES HAVING JURISDICTION.

ELECTRICAL NOTES:

- 1. ALL EXISTING ELECTRICAL ITEMS REQUIRED FOR LEGALIZATION SHALL BE SUBJECT TO BE REVIEWED AND CERTIFIED BY LICENSED ELECTRICAL CONTRACTOR AND REQUIRED PERMIT'S SHALL BE OBTAINED AS REQUIRED BY LOCAL JURISDICTION.
- 2. ALL WORK TO BE PERFORMED UNDER SUPERVISION OF A LICENSED ELECTRICAL
- 3. CONTRACTOR TO OBTAIN ALL PERMITS REQUIRED TO COMPLETE WORK AND SCHEDULE NECESSARY INSPECTIONS WITH LOCAL AUTHORTIES
- 4. ELECTRICAL OUTLET PLACEMENT IS FOR LOCATION ONLY, COORDINATE INSTALLATION WITH ALL TRADE WORK.
- 5. ALL EQUIPMENT TO BE INSTALLED AS PER MANUFACTURERS SPECIFICATIONS.

PLUMBING

- 1. ALL EXISTING PLUMBING ITEMS REQUIRED FOR LEGALIZATION SHALL BE SUBJECT TO BE REVIEWED AND CERTIFIED BY LICENSED PLUMBING CONTRACTOR AND REQUIRED PERMITS SHALL BE OBTAINED AS REQUIRED BY LOCAL JURISDICTION.
- 2. PLUMBING COMPONENTS, EQUIPMENTS AND SYSTEMS SHALL BE INSTALLED AND MAINTAINED IN ACCORDANCE WITH THE PLUMBING CODE.
- 3. ALL WORK TO BE PERFORMED UNDER SUPERVISION OF A LICENSED TRADE PROFESSIONAL. CONTRACTOR TO OBTAIN ALL PERMITS REQUIRED TO COMPLETE WORK AND SCHEDULE NECESSARY INSPECTIONS WITH LOCAL AUTHORITIES

SMOKE DETECTION AND NOTIFICATION NOTES:

- 1. EXISTING DWELLINGS UNDERGOING REPAIR, ALTERATION CHANGE OF OCCUPANCY, ADDITION OR RELOCATION SHALL BE PROVIDED WITH SMOKE ALARMS IN COMPLIANCE WITH LOCAL BUILDING CODE.
- ALL COMBINATION SMOKE AND CARBON MONOXIDE ALARMS SHALL BE LISTED IN ACCORDANCE WITH UL 217 AND INSTALLED IN ACCORDANCE WITH THE RESIDENTIAL CODE AND NFPA 72
- 3. ALL EXISTING SMOKE, CO & HEAT DETECTORS SHALL REMAIN IN EXISTING LOCATIONS. DETECTORS SHALL BE TESTED TO ENSURE IN WORKING CONDITIONS AND INSTALLED AT ALL LOCATIONS AS LISTED BELOW.

REQUIRED LOCATIONS:

- 1. IN EACH SLEEPING ROOM
- 2. OUTSIDE EACH SEPARATE SLEEPING AREA IN THE IMMEDIATE VICINITY OF BEDROOMS. 3. ON EACH STORY OF THE DWELLING, INCLUDING BASEMENTS BUT NOT CRAWL SPACES AND UNINHABITABLE ATTICS.
- 4. ALARMS SHALL BE INTERCONNECTED IN SUCH A MANNER THAT THE ACTUATION OF ONE ALARM WILL ACTIVATE ALL OF THE ALARMS IN THE INDIVIDUAL UNIT.

SYMBOL	DESCRIPTION	SYMBOL	DESCRIPTION
	EXIST INTERIOR WALL	Θ	EXHAUST FAN
	EXST EXTERIOR WALL	⊗ ⊗¢	EXHUAST FAN AND LIGHT
TOPOGRADISTA LIDARA INTERATOR	NEW EXTERIOR WALL	Ø	LIGHT FIXTURE
	NEW INTERIOR WALL	18	WALL MOUNTED LIGHT FIXTURE
202525	CONCRETE WALL	÷	REFRIGERATOR OUTLET
	BLOCK WALL	GHC CHC	GFCI OUTLET
	BRICK EXST WALL		OUTLET
	2 LAYERED INT WALL	— Mod	DISHWASHER OUTLET
ERIORITE GRANILE GRANILE BROWNER BROWN	BASEMENT INSULATED WALL	(B	LAUNDRY HOOKUP
	BASEBOARD HEATER	(SD)	SMOKE DETECTOR
XD 3068	DOOR TAG		ELECTRICAL PANEL
W01>	WINDOW TAG	─ ⋈─	SHUT OFF VALVE
	CEILING FAN		WATER METER/ SHUTOFF
	STRUCTURAL ELEMENT		GAS METER
	WATER FILTER	0	MECHANICAL
0	OIL TANK	HAN	WATER HEATER
	CONCRETE ELEMENT		

NOTE: NOT ALL SYMBOLS LISTED MAY BE USED UNDER THIS DRAWING PACKAGE.

BASEMENT LEGALIZATION PERMIT PLANS FOR: 1 LANGDON AVENUE IRVINGTON, NY 10533









- WINDOWS TO BE INSTALLED AS PER DETAILS AND SPECIFICATIONS ON WINDOW SCHEDULE AND PLANS ALL UNITS SHALL HAVE CODE COMPLIANT INSULATION AND AIR INFILTRATION REQUIREMENTS.
- EXISTING AND/OR NEW WINDOW FRAME OPENINGS SHALL BE VERIFIED IN FIELD BY INSTALLING CONTRACTOR PRIOR TO PURCHASE AND INSTALLATION.
- 4. WINDOWS INDICATED ON PLAN AS EGRESS TYPE WINDOWS SHALL MEET MINIMUM EMERGENCY EGRESS REQUIREMENTS AS PER SECTION R310 OF THE RESIDENTIAL BUILDING CODE.


LIGHT & VENTILATION CALCULATIONS												
ROOM	AREA (SF)	REQUIRED VENTILATION (SF -4%)	REQUIRED LIGHT (SF- 8%)	PROPOSED VENTILATION (SF)	PROPOSED LIGHT (SF)							
BEDROOM	255	10.2	20.4	12.67	12.67							
LIVING ROOM	107	4.28	8.56	12.67	12.67							

		DOOR SCHEI	DULE						
NO.	MANUFACTURER	DESCRIPTION	SIZE (W x H)	NOTES					
D14	EXISTING	PRIMED SOLID CORE HINGED	1'-4" x 6'-8"	SEEK OWNER APPROVAL FOR ALTERNATE					
D20	EXISTING	PRIMED SOLID CORE HINGED	2'-0" x 6'-8"	SEEK OWNER APPROVAL FOR ALTERNATE					
D24	EXISTING	STING PRIMED SOLID CORE HINGED		SEEK OWNER APPROVAL FOR ALTERNATE					
D26	EXISTING	EXISTING PRIMED SOLID CORE HINGED		SEEK OWNER APPROVAL FOR ALTERNATE					
FD26	EXISTING 20 MINUTE FIRE RATED DOOR		2'-6" x 6'-8"	PROVIDE SELF CLOSING HINGE AS REQUIRED BY R302.5.1					

			R	OC	ЭM	FI	NI	SH	I SC	CH	EΓ)UI	LE										
	FLOOR				WALL					CEIL'G			DR. TRIM				WIND. T			(II			
DOOM NAME	MAT"L.		FINISH		MAT"L.		FINISH		M	FIN		MAT		FIN		MAT		FIN					
ROOM NAME	CARPET	VINYL	CER. TILE	MANUFA CTUR.	PAINTED	GROUT	GYP. BD	B. MLDG	CER. TILE	PRIMED	PAINTED	GROUT	GYP. BD	PRIMED	PAINTED	WOOD	METAL	STAINED	PAINTED	WOOD	METAL	STAINED	PAINTED
LIVING ROOM			X	х		х	х			X	Х		Х	X	Х	X			х	Х			x
BEDROOM			X	х		х	х			X	Х		х	X	х	Х			х	х			х
BATHROOM			X	х		х	х			X	Х		Х	X	Х	X			х	Х			×

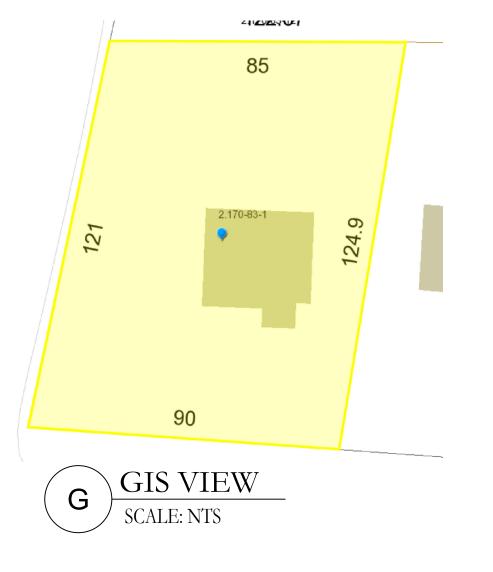

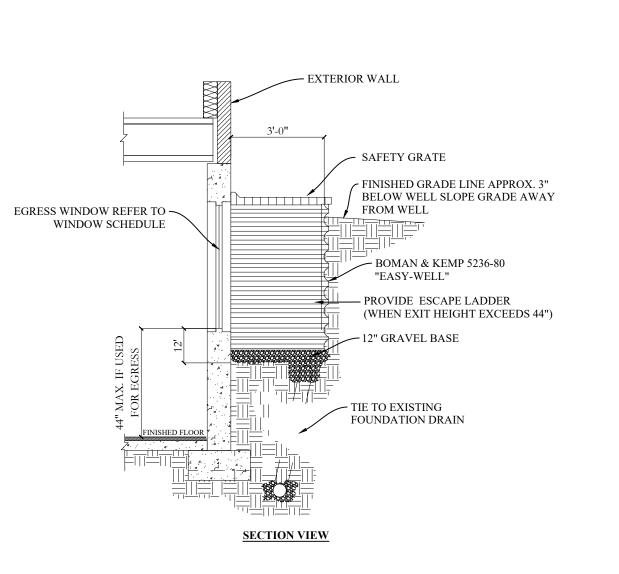


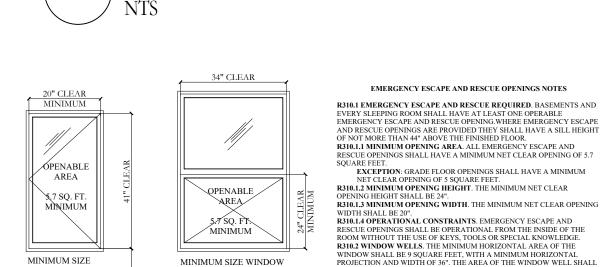



MINIMUM SIZE WINDOW

EGRESS WINDOW DETAIL 2



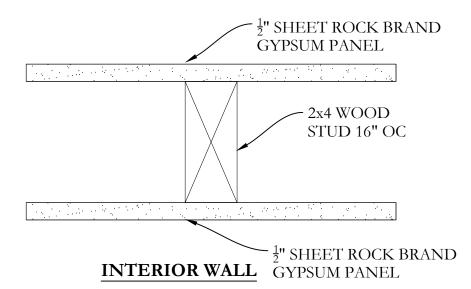

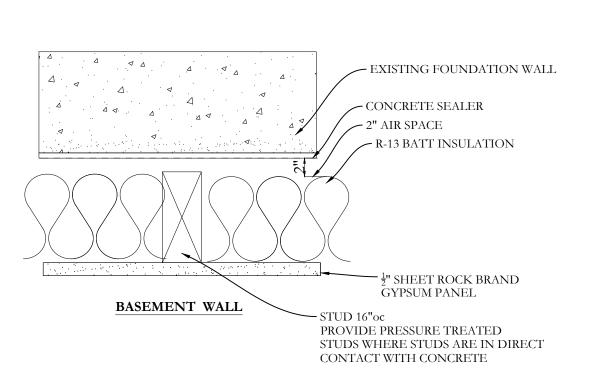

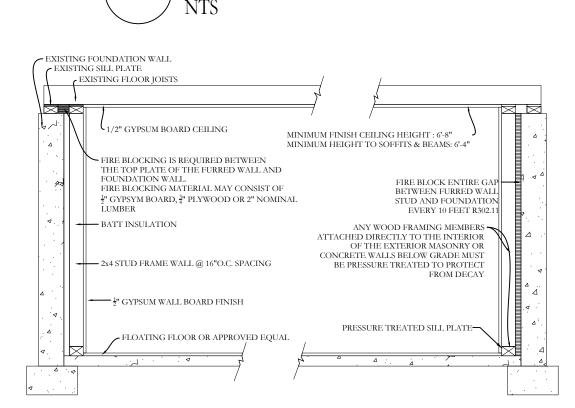

WALL DETAILS

WALL DETAILS 2



www.ResReal.com (914)-330-7712

361 Route 202 - Suite #7 Somers, NY 10589

PROPERTY INFORMATION: PREPARED BY: JMS ENGINEERING SERVICES, PC PROJECT LOCATION: 1 LANGDON AVENUE PROJECT TOWN: IRVINGTON, NY BUILDING DEPARTMENT: VILLAGE OF IRVINGTON PROPERTY IDENTIFICATION: 2.170-83-1 OCCUPANCY: SINGLE FAMILY DWELLING ZONING CODE: 1F-40

CHECKED: APPROVED: JMS 0 02/14/2022

SEAL & SIGNATURE:

> JOHN M. SCAVELLI PE LICENSE # 095178 JMS ENGINEERING SERVICES, PC

IT IS A VIOLATION OF STATE LAW FOR ANY PERSON UNLESS DIRECTED BY A REGISTERED ARCHITECT OR PROFESSIONAL ENGINEER TO ALTER THIS ITEM IN ANY WAY.

PROJECT:

1 Langdon Avenue Irvington, NY 10533

DRAWING TITLE: PLANS & DETAILS SHEET 1

A-101

